



NORTH

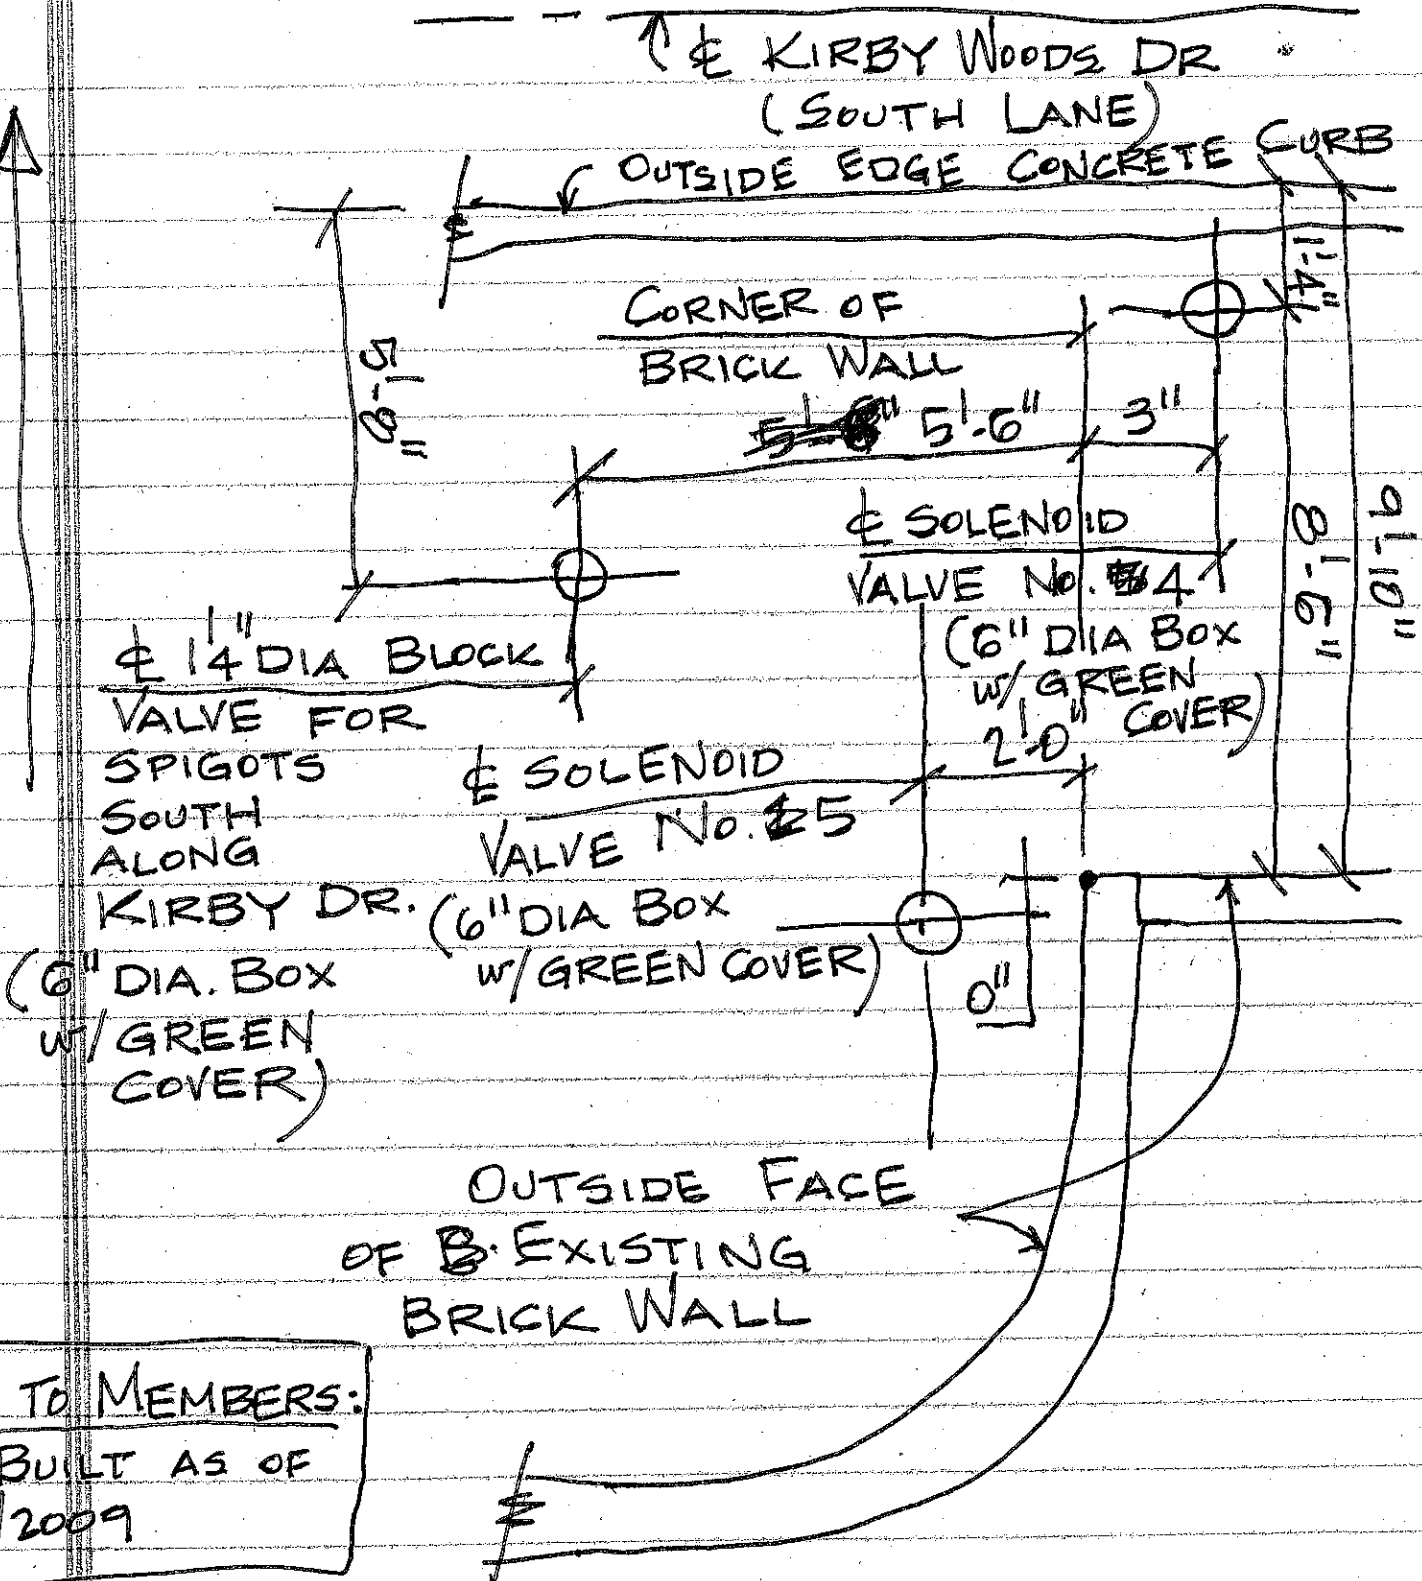

NOTE TO MEMBERS:  
AS BUILT AS OF  
4/23/2009

PARTIAL PLAN - KIRBY WOODS ENTRANCE  
SPRINKLER VALVE BOX LAYOUT - SHT. 1 OF 3

SCALE: NONE  
DRAWN BY: K. KARLMAN

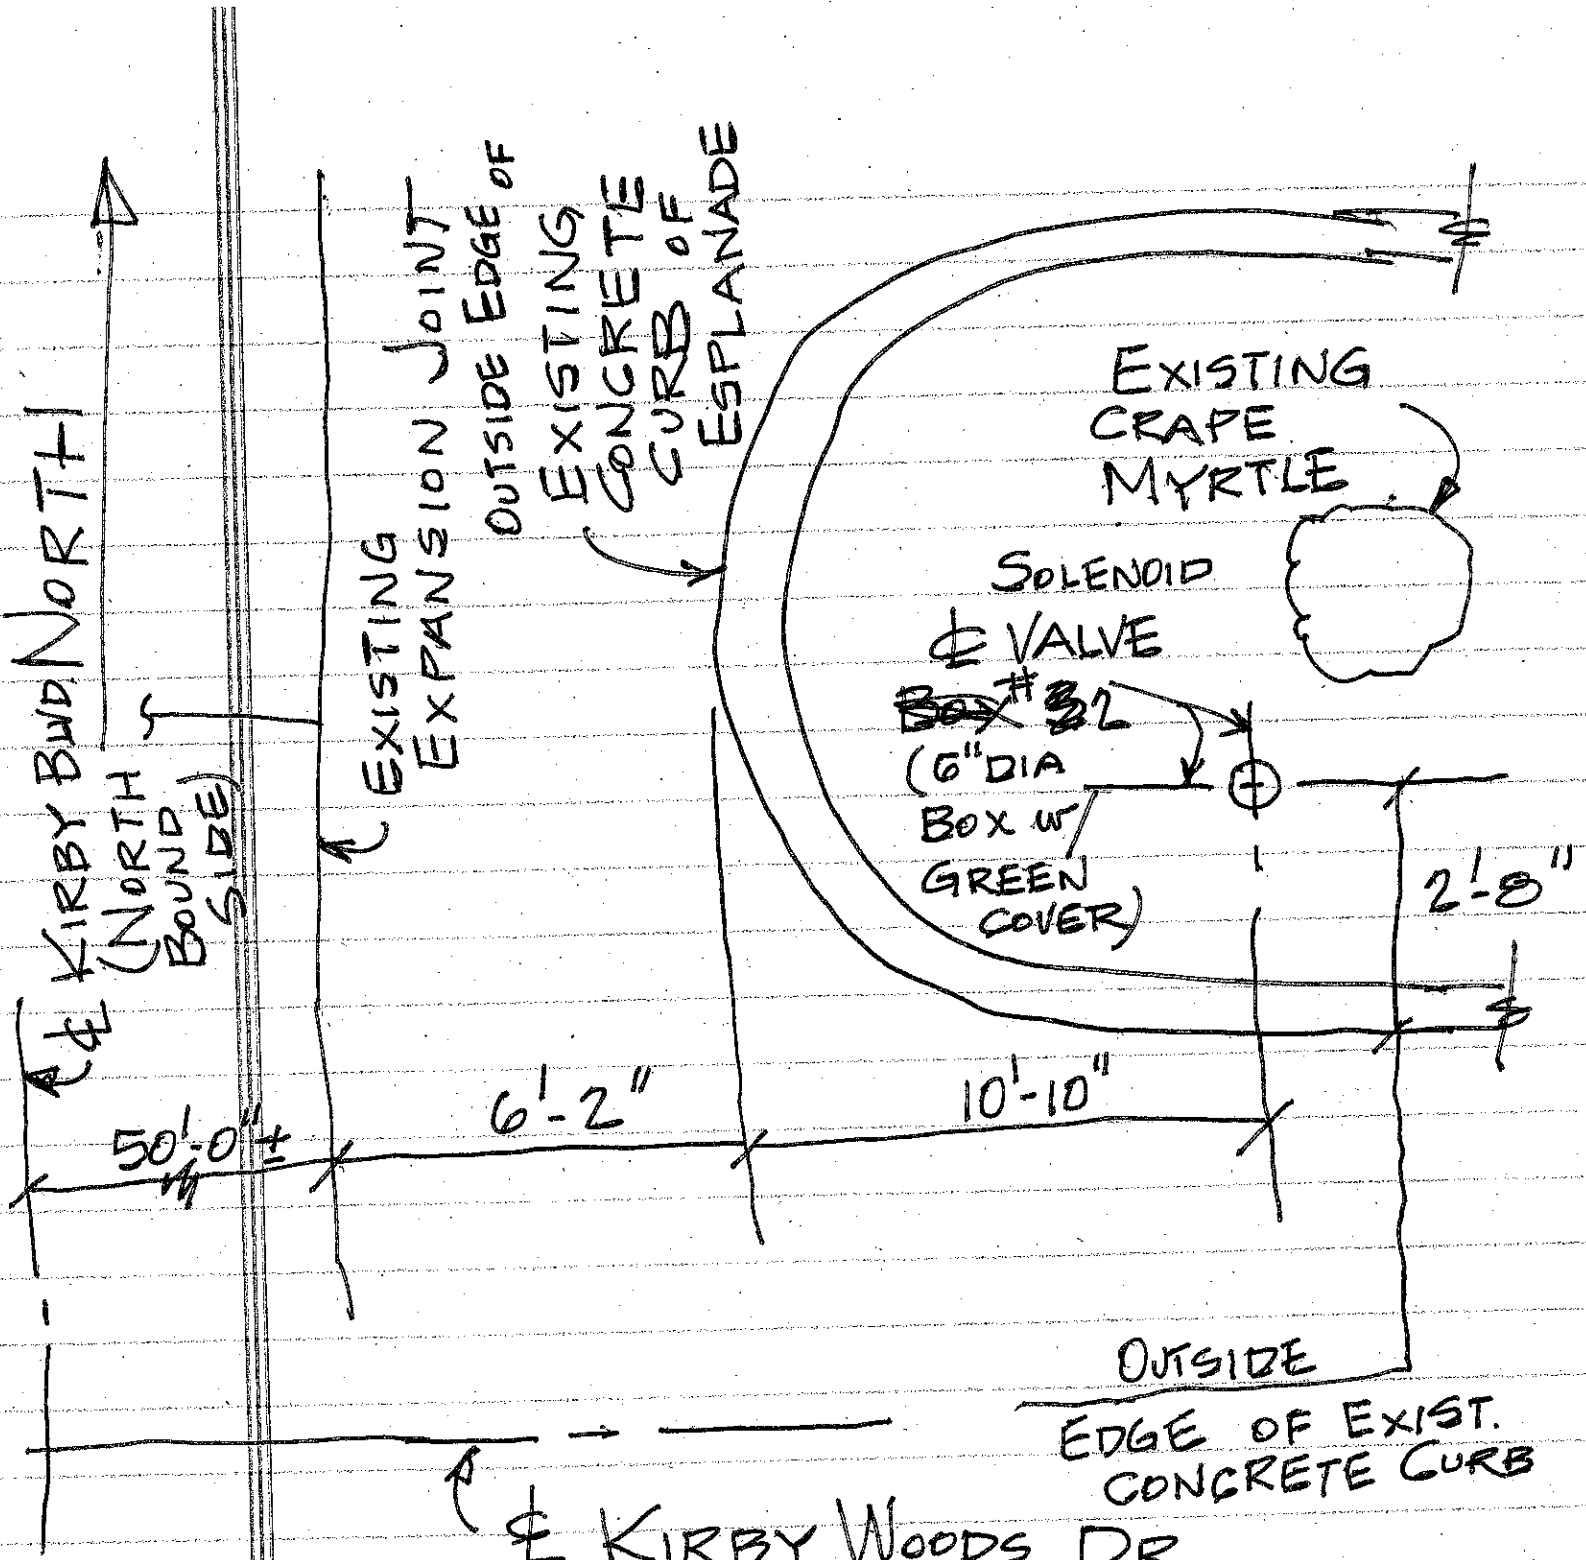


NOTE TO MEMBERS:  
 AS-BUILT SKETCH  
 AS OF 4/23/2009

PARTIAL PLAN - KIRBY WOODS ENTRANCE  
 SPRINKLER VALVE BOX LAYOUT - SHT. 2 OF 3

SCALE: NONE  
 DRAWN BY: K. KARLMAN

NORTH

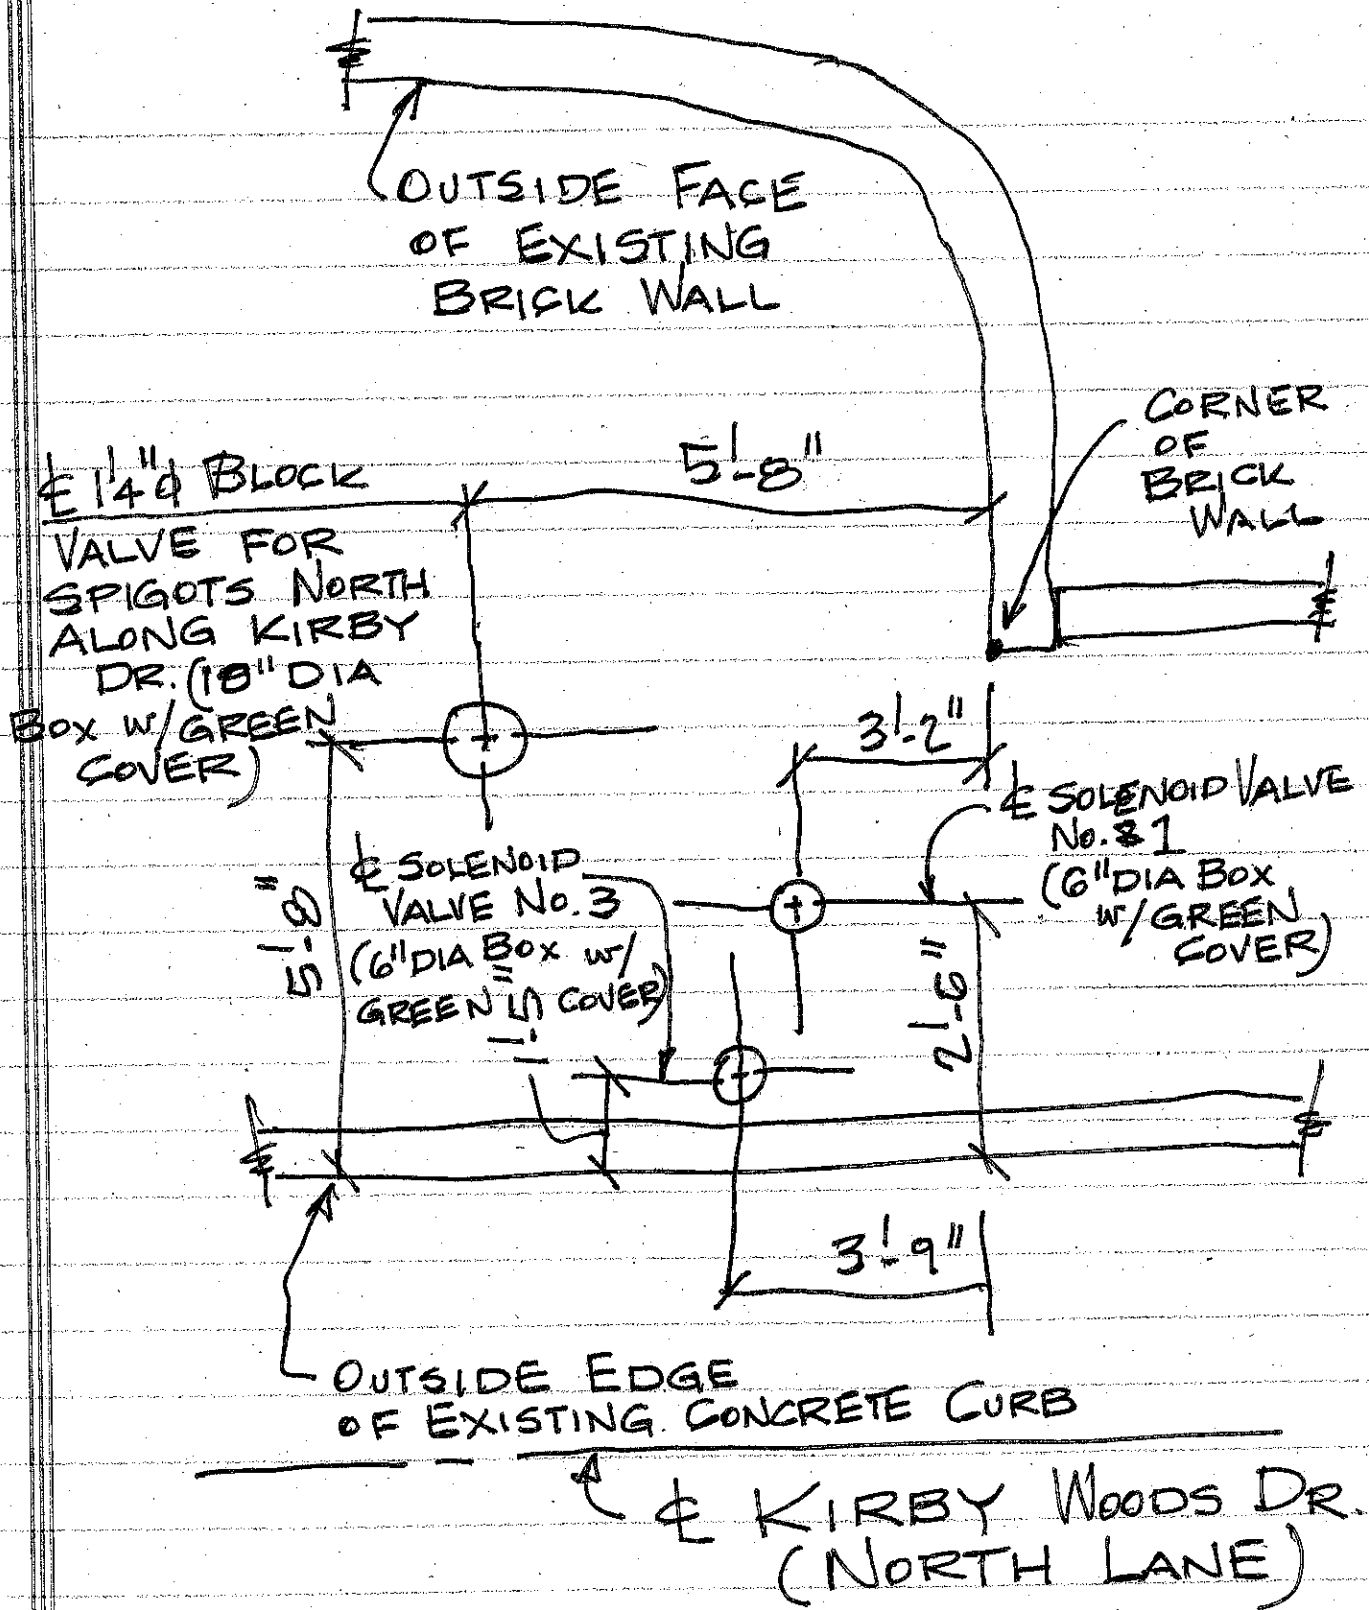

PARTIAL PLAN - KIRBY WOODS ENTRANCE  
SPRINKLER VALVE BOX LAYOUT - SHT. 3 OF 3

SCALE: NONE  
DRAWN BY: K. KARLMAN